



THE SENATOR

1121 L STREET


SUITE 104
± 1,881 RSF
AVAILABLE 1/1/2023

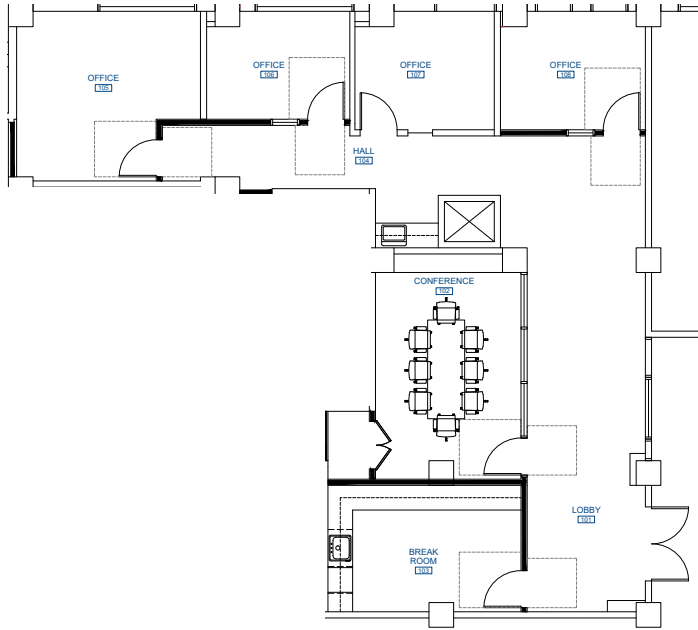

TEST FIT

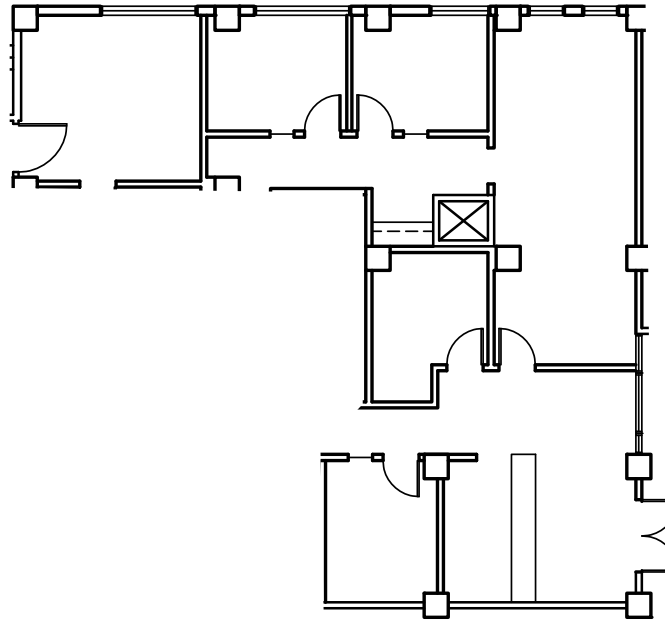

AS-BUILT

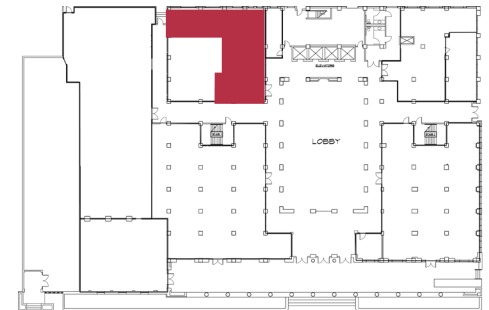

CONTACT

Greg Levi
+1 916 491 4310
RE License #00973235
greg.levi@am.jll.com

Alexis Garrett
+1 916 491 4316
RE License #01836361
alexis.garrett@am.jll.com



Jones Lang LaSalle Brokerage, Inc. RE License #01856260